

Pardoa Boulevard



- Wastewater
- Wastewater Connection
- Existing Wastewater

Pardoa Boulevard

501

502

503


811

812

813

814

815

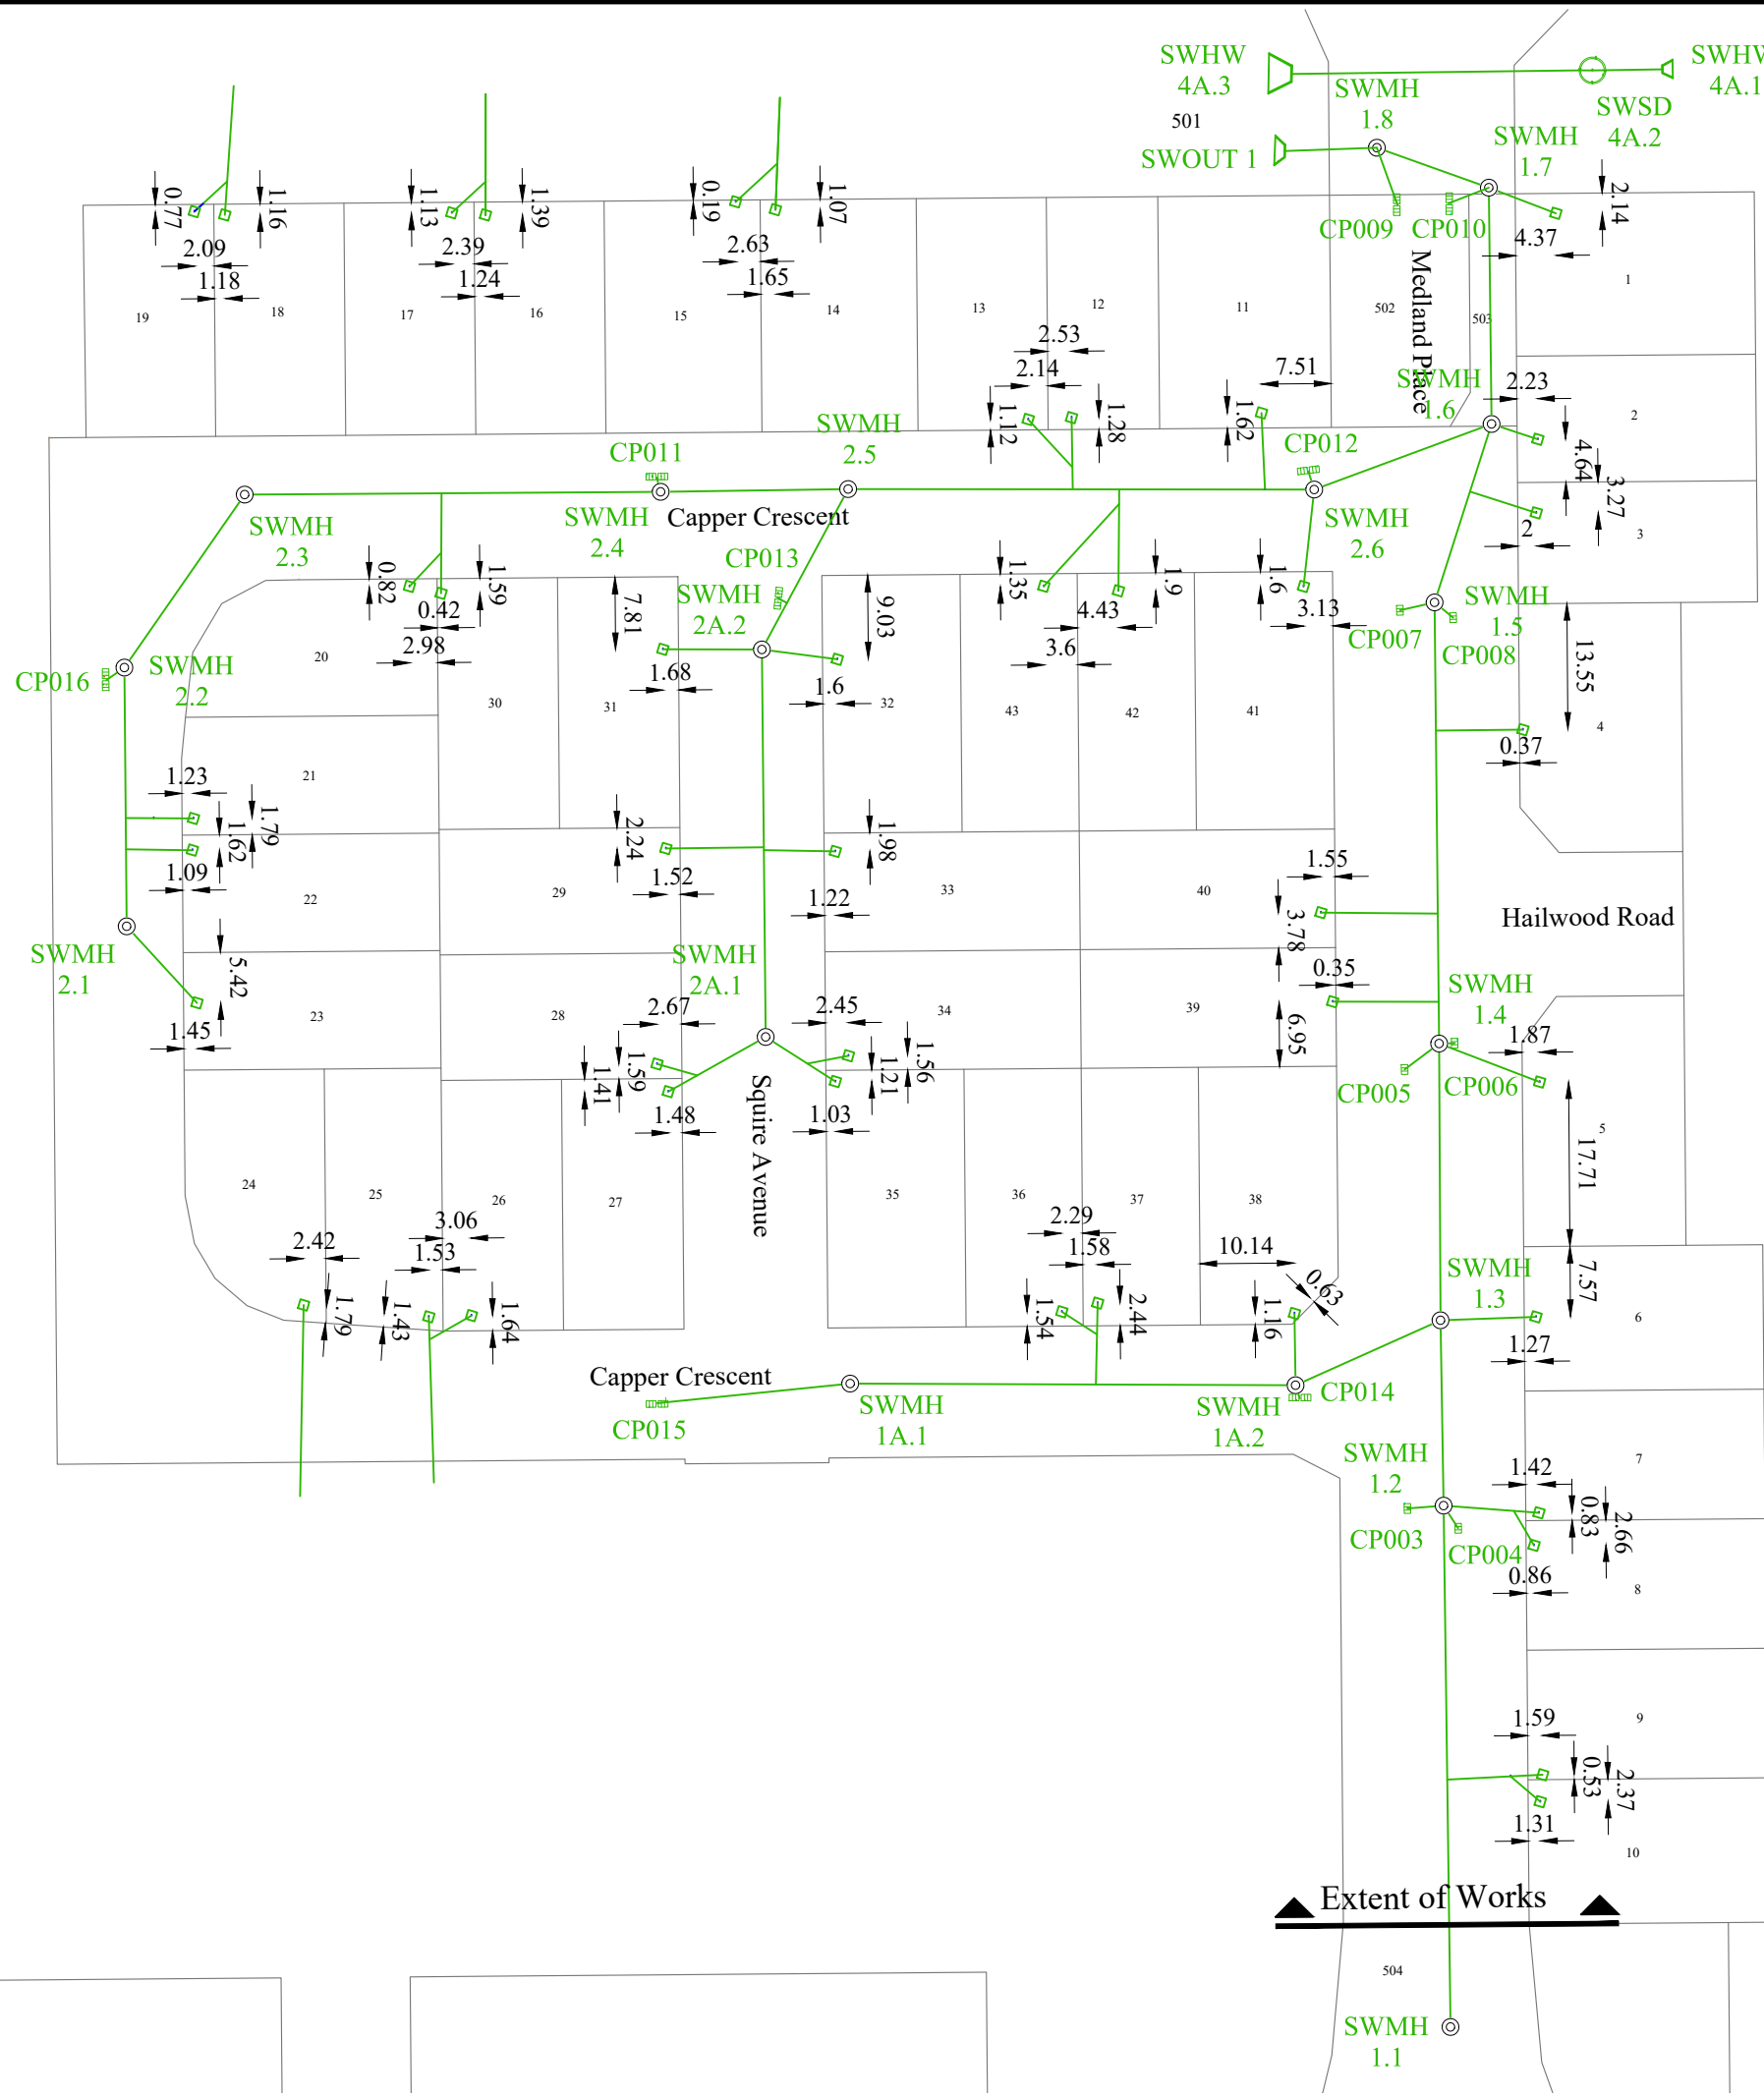

- Stormwater
- Stormwater Connection
- Under Swale Drain
- Existing Stormwater

Description	Easting	Northing	Lid Level	Invert Level, Outfall Clockwise
SWMH 1.1	447083.16	703090.91	-	Next Stage
SWMH 1.2	447066.42	703144.49	37.17	35.47, 35.75, 35.75, 35.53, 35.89
SWMH 1.3	447060.40	703163.52	37.11	35.25, 35.60, 35.27, 35.27
SWMH 1.4	447051.75	703192.03	37.00	35.10, 35.73, 35.55, 35.12, 35.64
SWMH 1.5	447037.72	703237.40	36.82	34.86, 35.55, 34.90, 35.52
SWMH 1.6	447038.11	703257.57	36.88	34.62, 35.07, 34.77, 34.88
SWMH 1.7	447030.56	703281.87	36.84	34.53, 35.27, 34.55, 35.50
SWMH 1.8	447017.78	703282.55	36.75	34.47, 34.48, 35.30
SWOUT 1.1	447008.34	703279.36	36.07	34.44
SWMH 2.1	446912.69	703163.76	37.24	35.89, 36.11
SWMH 2.2	446904.50	703190.39	37.12	35.71, 35.76, 35.82
SWMH 2.3	446911.60	703211.94	36.99	35.50, 35.58
SWMH 2.4	446954.44	703225.01	36.73	35.25, 35.29, 35.51
SWMH 2.5	446973.71	703231.06	36.64	35.07, 35.27, 35.15
SWMH 2.6	447021.82	703245.35	36.42	34.92, 35.30, 34.95, 35.15
SWMH 1A.1	447001.42	703138.83	37.04	35.65, 35.72
SWMH 1A.2	447047.43	703152.36	36.73	35.35, 35.39, 35.37, 35.63
SWMH 2A.1	446982.04	703172.00	37.17	35.63, 35.67, 35.67
SWMH 2A.2	446969.74	703211.86	36.95	35.37, 35.64, 35.42, 35.62
SWHW 4A.1	447044.88	703299.42	34.78	33.93
SWSD 4A.2	447037.65	703297.15	36.15	33.83, 33.93
SWHW 4A.3	447006.66	703287.52	35.77	33.75

Checked by	2	Lot 22 SW Lateral Amended	08/17
Rev	1	Issued for Works Clearance	07/17
No			
NAME	DATE	SIGNED	
Surveyed	SC	05/17	
Designed	SM	06/15	
Drawn	ADP	07/17	
Checked	SC	07/17	
Approved	TAM	07/17	

REFERENCES  
**Note:**  
All levels are in terms of Moturiki Datum.  
Origin of Levels : SS507 SO 42451 (EP6K) RL: 44.04  
Source: LINZ Geodetic Database  
Location: Corner of Carrs Road and Tramway Road  
All Coordinates are in Terms of Mount Eden 2000



**S & L CONSULTANTS LTD**  
SURVEYORS - ENGINEERS - PLANNERS  
102 Hamilton Street, Tauranga, New Zealand  
P.O. Box 231 Ph.(07)577-6069  
Fax(07)577-6065  
Email: slconsultants@sltga.co.nz

TITLE

Chedworth Properties Ltd

Greenhill Park, Hamilton

Stage 5

Stormwater Asbuilt Plan

Copyright on this drawing is reserved

ORIGINAL SCALES

Scale 1:750 @ A3

DRAWING No

21338- AB3


Revision:

1 2

DATE

07/17

METRIC DESIGN

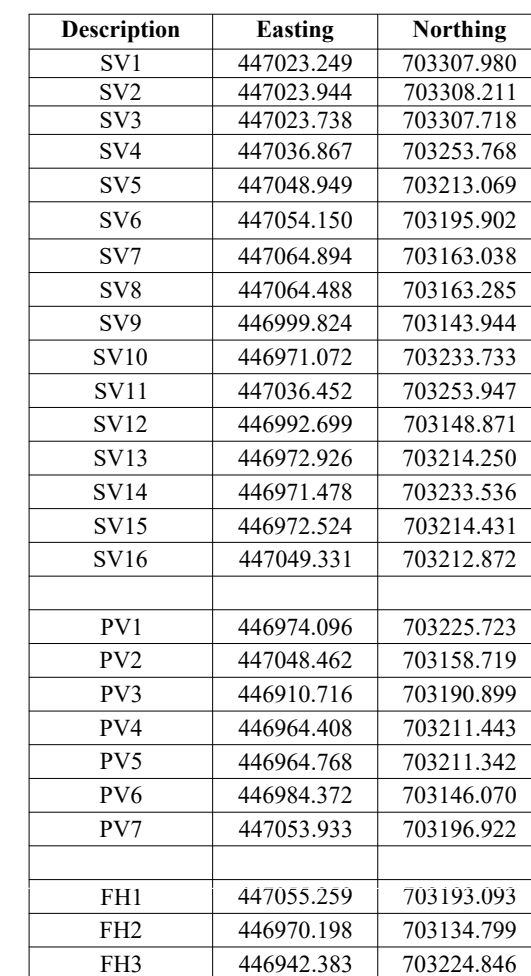

	1	Issued for Works Clearance	07/17
checked by	Rev. No.	Description	DATE
		NAME	DATE
			SIGNED
Surveyed	SC	07/16	
Designed	CR	06/15	
Drawn	ADP	07/17	
Checked	SC	07/17	
Approved	TAM	07/17	

## REFERENCES

**Note:**

All levels are in terms of Moturiki Datum.  
Origin of Levels : SS507 SO 42451 (EP6K) RL: 44.04  
Source: LINZ Geodetic Database  
Location: Corner of Carrs Road and Tramway Road  
All Coordinates are in Terms of Mount Eden 2000



**S & L CONSULTANTS LTD**  
SURVEYORS - ENGINEERS - PLANNERS

102 Hamilton Street, Tauranga, New Zealand  
P.O. Box 231 Ph.(07)577-6069  
Fax(07)577-6065  
Email: [slconsultants@sltga.co.nz](mailto:slconsultants@sltga.co.nz)

TITLE

Chedworth Properties Ltd

Greenhill Park, Hamilton  
Stage 5

## Water Asbuilt Plan

Copyright on this drawing is reserved

Scale 1:750 @ A3

DRAWING No.

21338 - AB4

Revision

--	--

1

[illegible]

--	--


--	--


F

1

*METH*  
DEOL

**II**  
**MET**

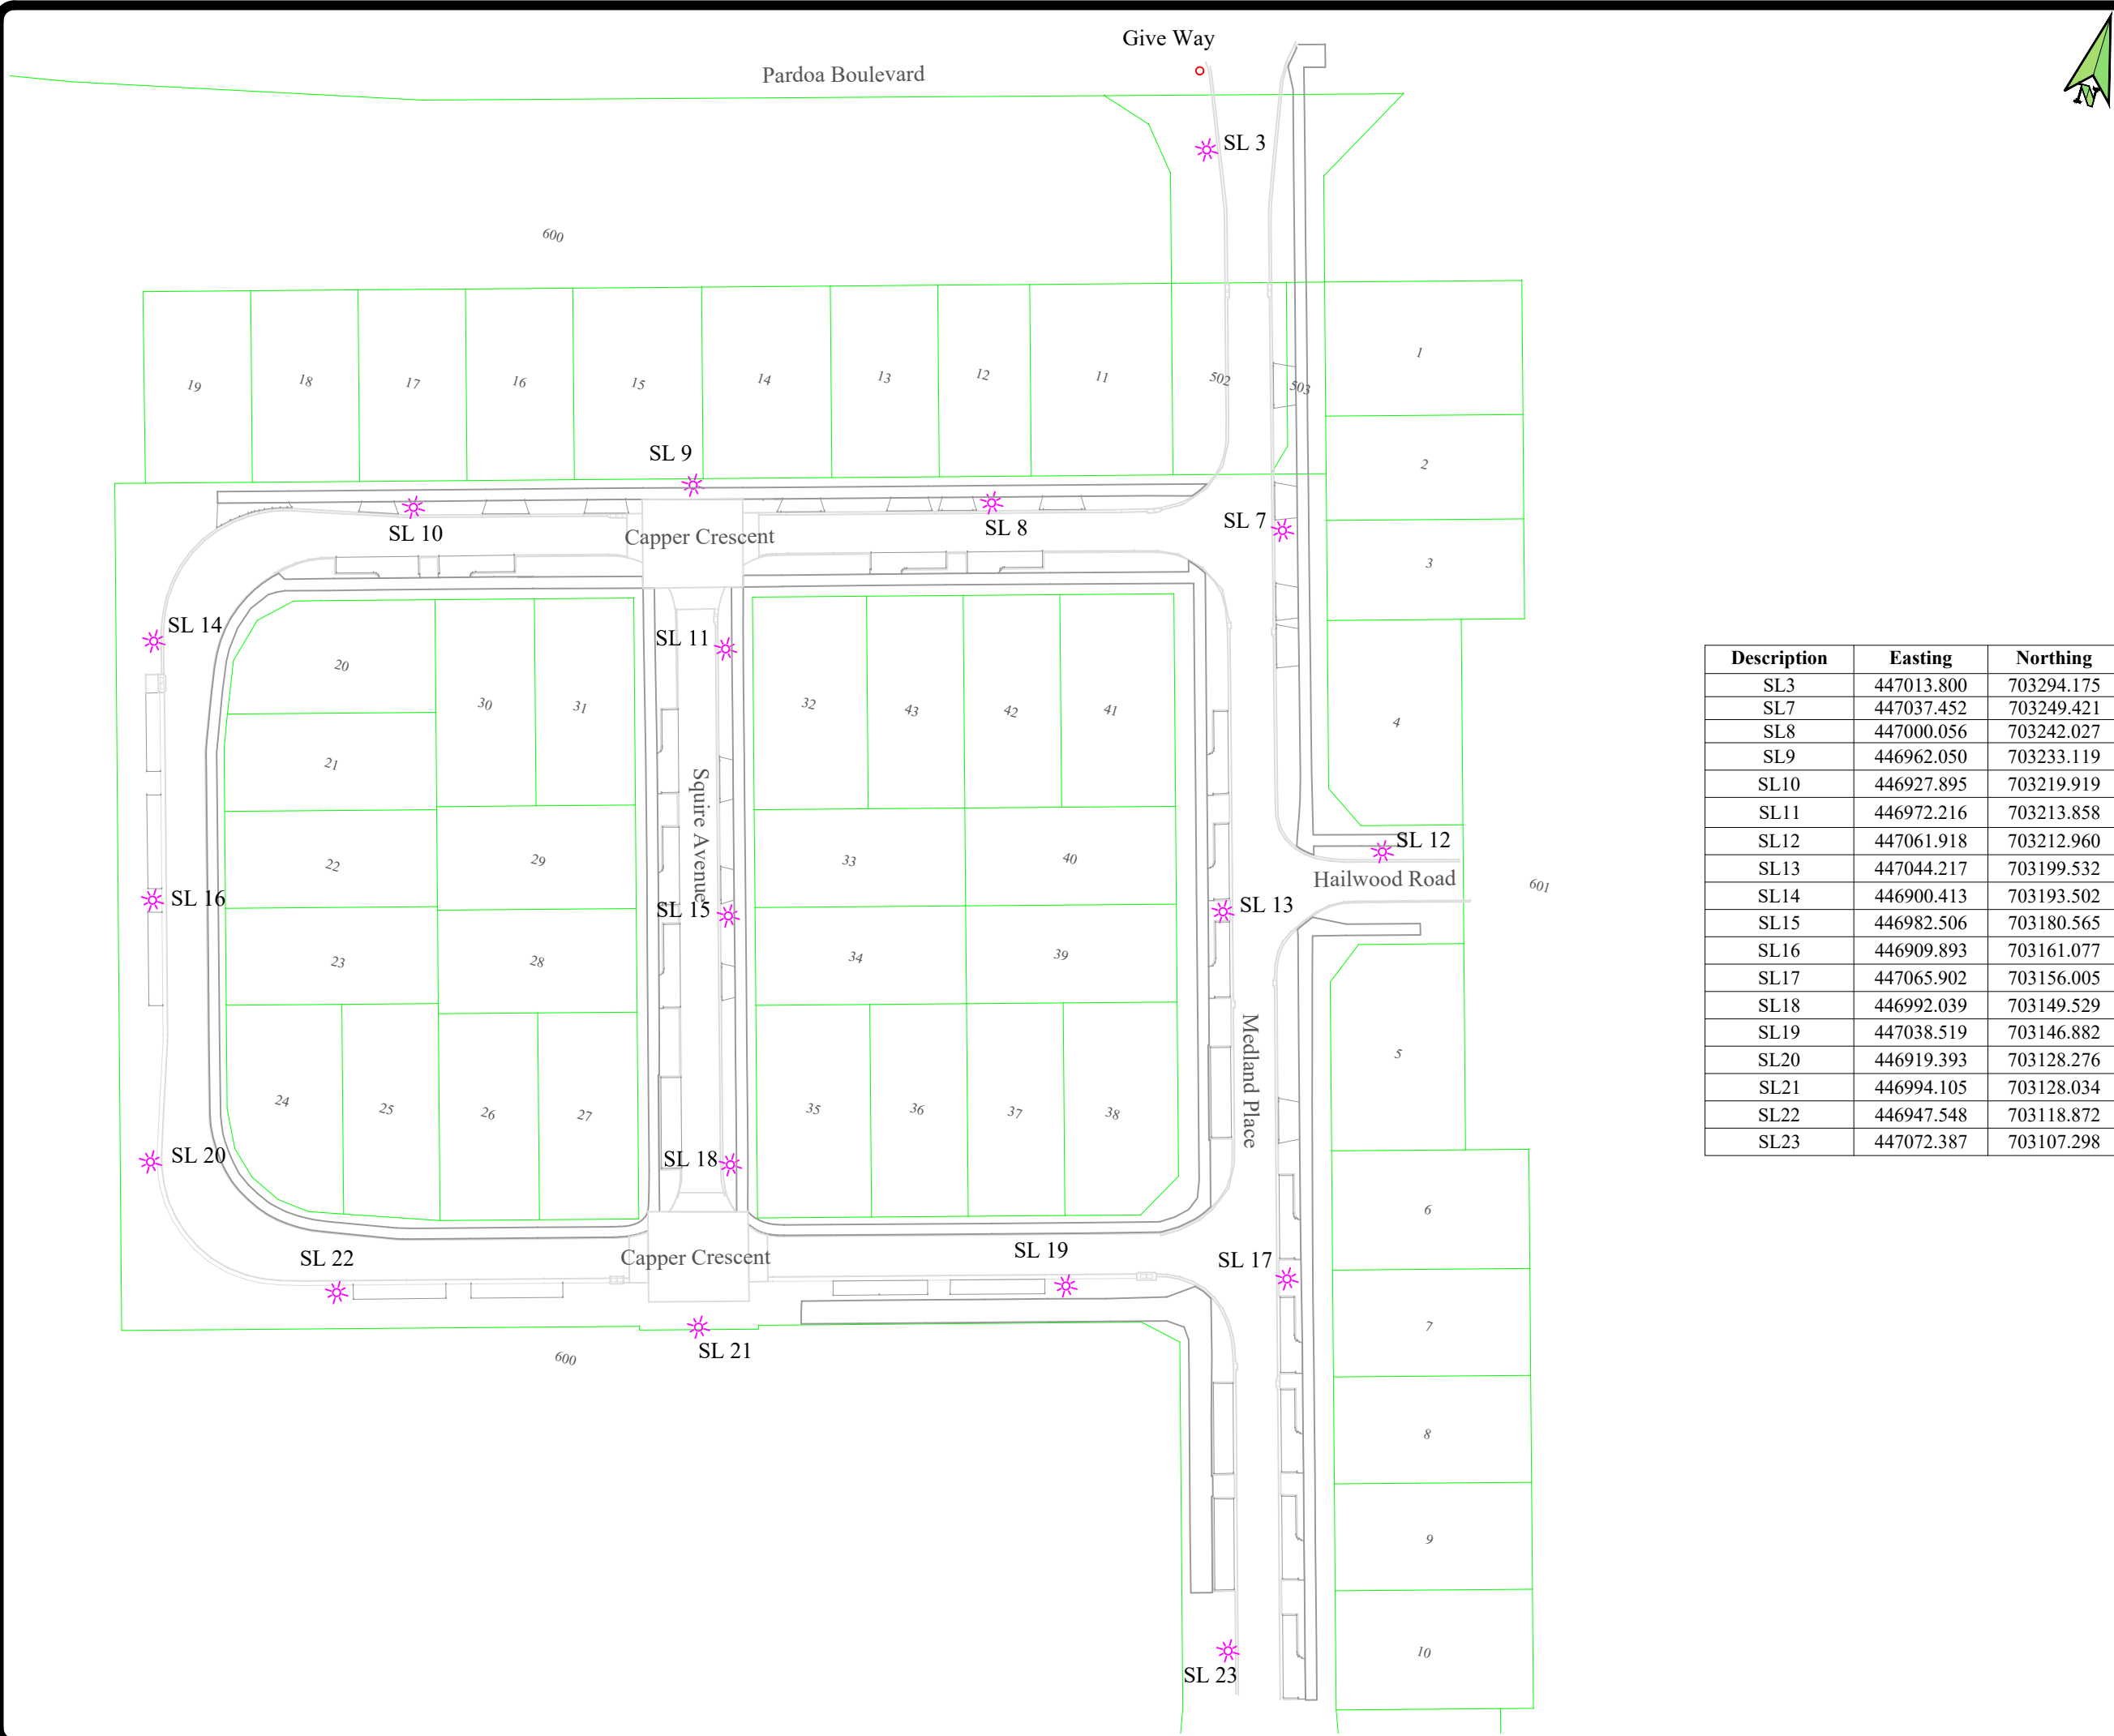

Description	Easting	Northing
SL3	447013.800	703294.175
SL7	447037.452	703249.421
SL8	447000.056	703242.027
SL9	446962.050	703233.119
SL10	446927.895	703219.919
SL11	446972.216	703213.858
SL12	447061.918	703212.960
SL13	447044.217	703199.532
SL14	446900.413	703193.502
SL15	446982.506	703180.565
SL16	446909.893	703161.077
SL17	447065.902	703156.005
SL18	446992.039	703149.529
SL19	447038.519	703146.882
SL20	446919.393	703128.276
SL21	446994.105	703128.034
SL22	446947.548	703118.872
SL23	447072.387	703107.298

Notes

Coordinates are in terms of Mount Eden 2000

1


Issued for Works Clearance

07/17

Checked by	Rev No	Description	DATE
Surveyed	SC	06/17	
Designed	CR	06/15	
Drawn	HC	07/17	
Checked	SC	07/17	
Approved	TAM	07/17	

REFERENCES

Note:  
All levels are in terms of Moturiki Datum.  
Origin of Levels : SS507 SO 42451 (EP6K) RL: 44.04  
Source: LINZ Geodetic Database  
Location: Corner of Carrs Road and Tramway Road  
All Coordinates are in Terms of Mount Eden 2000



S & L CONSULTANTS LTD

S & L CONSULTANTS LTD  
SURVEYORS - ENGINEERS - PLANNERS

102 Hamilton Street, Tauranga, New Zealand  
P.O. Box 231 Ph:(07)577-6069  
Fax:(07)577-6065  
Email: slconsultants@sltga.co.nz

TITLE

Chedworth Properties Ltd

Greenhill Park, Hamilton  
Stage 5

Roading Asbuilt Plan

Copyright on this drawing is reserved

ORIGINAL SCALES

Scale 1:750 @ A3

DATE


07/17

DRAWING No

21338 - AB5

Revision:

1







Name	Easting	Northing
SL24	447092.23	703083.65
SL25	447070.89	703068.42
SL26	447108.77	703063.02
SL27	447034.82	703055.69
SL28	447086.14	703047.43
SL29	447002.77	703042.91
SL30	446972.41	703036.61
SL31	447047.38	703029.20
SL33	446933.30	703021.64
SL34	446985.74	703016.03
SL35	446910.92	702991.47
SL37	447063.41	702976.54
SL38	446999.91	702969.78
SL40	446922.27	702954.94
SL42	447010.29	702936.10
SL43	447077.88	702929.78
SL44	446934.58	702914.55
SL46	447021.89	702908.35
SL47	447006.10	702894.79
SL48	446957.93	702887.75
SL49	447093.74	702883.68
SL50	446941.94	702879.53
SL51	447078.53	702875.53
SL52	447036.70	702870.91
SL54	447021.25	702861.26
SL55	447102.88	702848.68
SL56	446957.52	702839.57
SL57	447042.49	702830.96
SL60	447119.53	702805.21
SL61	446970.00	702798.76
SL62	447053.19	702796.10
SL64	447132.74	702776.77
SL66	446984.71	702749.78
SL67	447071.27	702748.68
SL68	447147.45	702749.69
SL70	447055.06	702741.72
SL71	447014.84	702729.26

**Notes:**  
Coordinates are in terms of Mt Eden 2000 Circuit  
  
Levels are in terms of Moturiki Vertical Datum 1953  
Origin of Levels: SS507 SO 42451 (EP6K) RL:44.04  
Source: LINZ Geodetic Database  
Location: Corner of Carrs Road and Tramway Road (under cover)  
  
To be read in conjunction with S&L Consultants Drawing 21338 - AB7 - R0

CKD BY	0	Issued For Work Clearance	11/17
REV No.		DESCRIPTION	DATE
Surveyed		NAME	DATE
Designed		SIGNED	
Drawn		SRC	10/17
Checked		IBEX	08/17
Approved		SRC	11/17
		TAM	11/17

References



**HCC Ref:**  
**011.2016.00006256.001 & 011.2016.00006256.003**



**S & L CONSULTANTS LTD**  
SURVEYORS - ENGINEERS - PLANNERS  
36 Kereti Street, Mt Maunganui, New Zealand  
P.O. Box 231 Ph:(07)577-6069  
Fax(07)577-6065  
Email: slconsultants@slga.co.nz  
Web Site: www.slga.co.nz

Title

**Roading Asbuilt Plan  
Stage 6 & 7**



Copyright on this drawing is reserved

Original Scales @ A3	Date
1:1000	11/17
Do Not Scale Dimensions	
Drawing No	Revision
21338 - AB6	0



Name	Easting	Northing
SL24	447092.23	703083.65
SL25	447070.89	703068.42
SL26	447108.77	703063.02
SL27	447034.82	703055.69
SL28	447086.14	703047.43
SL29	447002.77	703042.91
SL30	446972.41	703036.61
SL31	447047.38	703029.20
SL33	446933.30	703021.64
SL34	446985.74	703016.03
SL35	446910.92	702991.47
SL37	447063.41	702976.54
SL38	446999.91	702969.78
SL40	446922.27	702954.94
SL42	447010.29	702936.10
SL43	447077.88	702929.78
SL44	446934.58	702914.55
SL46	447021.89	702908.35
SL47	447006.10	702894.79
SL48	446957.93	702887.75
SL49	447093.74	702883.68
SL50	446941.94	702879.53
SL51	447078.53	702875.53
SL52	447036.70	702870.91
SL54	447021.25	702861.26
SL55	447102.88	702848.68
SL56	446957.52	702839.57
SL57	447042.49	702830.96
SL60	447119.53	702805.21
SL61	446970.00	702798.76
SL62	447053.19	702796.10
SL64	447132.74	702776.77
SL66	446984.71	702749.78
SL67	447071.27	702748.68
SL68	447147.45	702749.69
SL70	447055.06	702741.72
SL71	447014.84	702729.26

**Notes:**  
Coordinates are in terms of Mt Eden 2000 Circuit  
  
Levels are in terms of Moturiki Vertical Datum 1953  
Origin of Levels: SS507 SO 42451 (EP6K) RL:44.04  
Source: LINZ Geodetic Database  
Location: Corner of Carrs Road and Tramway Road (under cover)  
  
To be read in conjunction with S&L Consultants Drawing 21338 - AB6 - R0

CKD BY	0	Issued For Work Clearance	11/17
REV No.		DESCRIPTION	DATE
		NAME	DATE
Surveyed		SRC	10/17
Designed		IBEX	08/17
Drawn		SRC	11/17
Checked		SRC	11/17
Approved		TAM	11/17



References  
  
**HCC Ref:**  
**011.2016.00006256.001 & 011.2016.00006256.003**



**S & L CONSULTANTS LTD**  
SURVEYORS · ENGINEERS · PLANNERS

36 Kereiti Street, Mt Maunganui, New Zealand  
P.O. Box 231 Ph.(07)577-6069  
Fax(07)577-6065  
Email: slconsultants@slga.co.nz  
Web Site: www.slga.co.nz


Title  
  
**Roading Asbuilt Plan  
Stage 6 & 7**



Copyright on this drawing is reserved

Original Scales @ A3	Date
1:1000	11/17
Do Not Scale Dimensions	
Drawing No	Revision
21338 - AB7	0



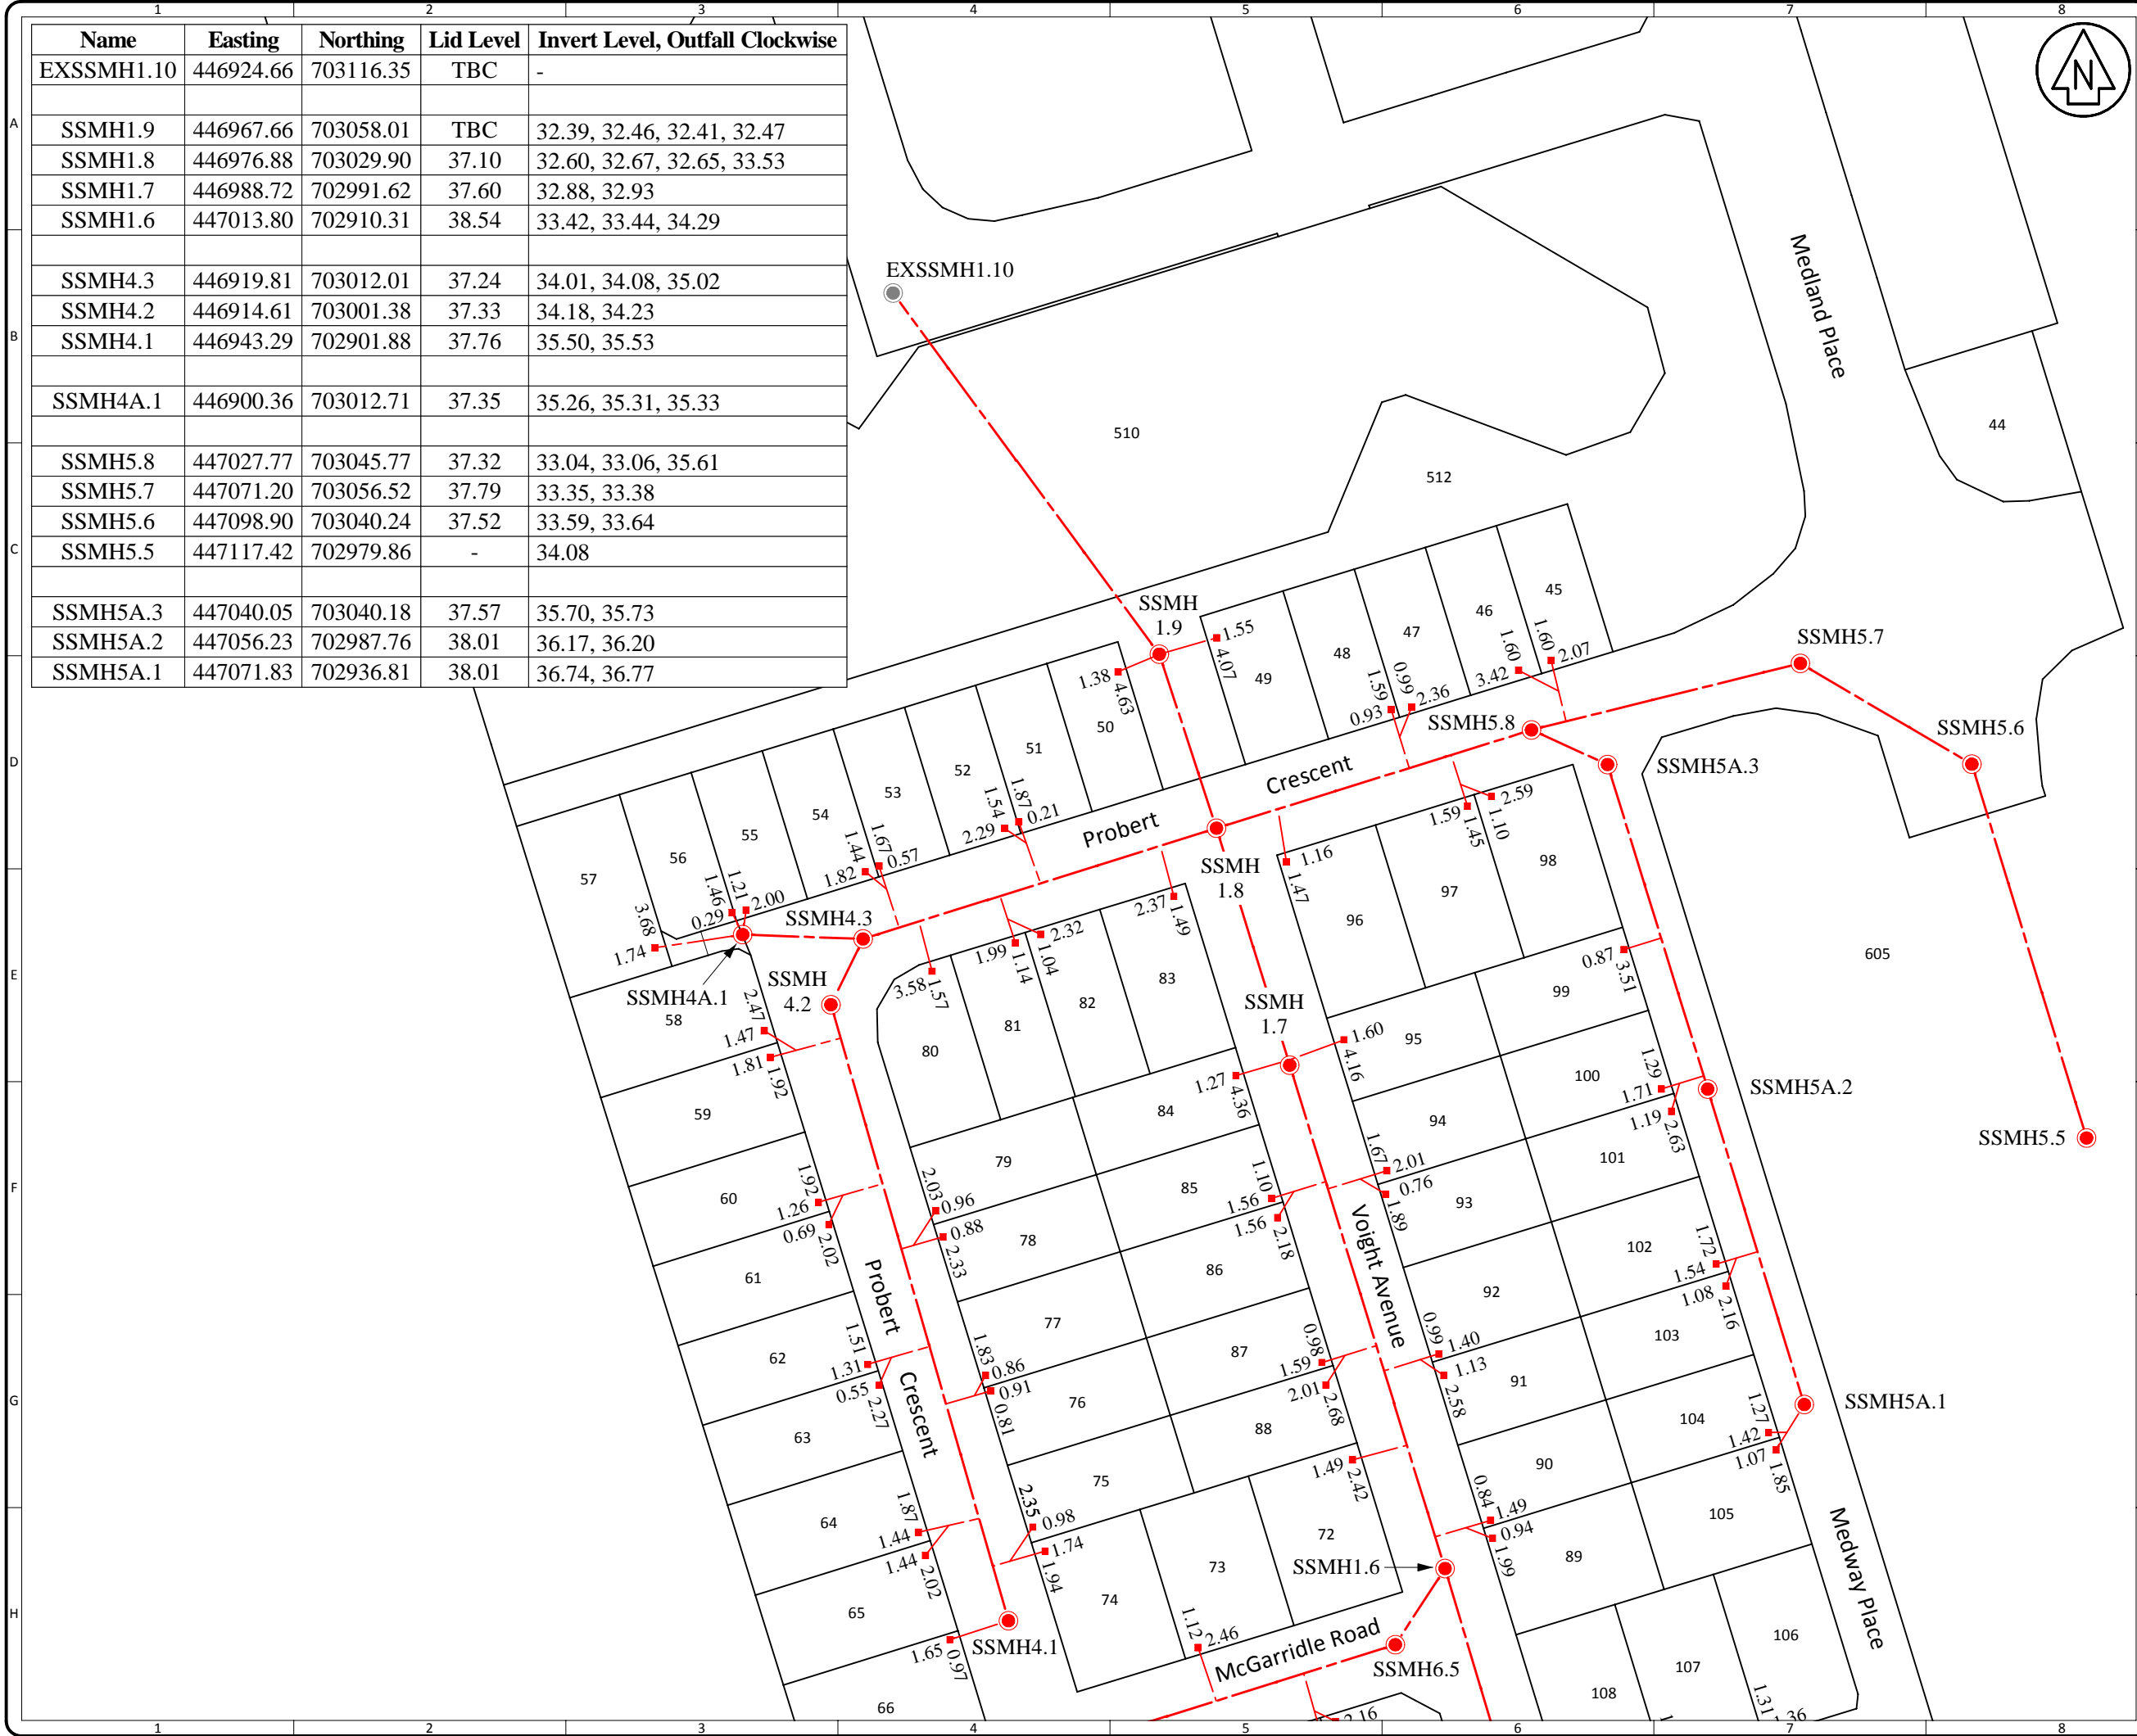

Name	Easting	Northing	Lid Level	Invert Level, Outfall Clockwise
EXSSMH1.10	446924.66	703116.35	TBC	-
SSMH1.9	446967.66	703058.01	TBC	32.39, 32.46, 32.41, 32.47
SSMH1.8	446976.88	703029.90	37.10	32.60, 32.67, 32.65, 33.53
SSMH1.7	446988.72	702991.62	37.60	32.88, 32.93
SSMH1.6	447013.80	702910.31	38.54	33.42, 33.44, 34.29
SSMH4.3	446919.81	703012.01	37.24	34.01, 34.08, 35.02
SSMH4.2	446914.61	703001.38	37.33	34.18, 34.23
SSMH4.1	446943.29	702901.88	37.76	35.50, 35.53
SSMH4A.1	446900.36	703012.71	37.35	35.26, 35.31, 35.33
SSMH5.8	447027.77	703045.77	37.32	33.04, 33.06, 35.61
SSMH5.7	447071.20	703056.52	37.79	33.35, 33.38
SSMH5.6	447098.90	703040.24	37.52	33.59, 33.64
SSMH5.5	447117.42	702979.86	-	34.08
SSMH5A.3	447040.05	703040.18	37.57	35.70, 35.73
SSMH5A.2	447056.23	702987.76	38.01	36.17, 36.20
SSMH5A.1	447071.83	702936.81	38.01	36.74, 36.77

**Notes:**  
Coordinates are in terms of Mt Eden 2000 Circuit

Levels are in terms of Moturiki Vertical Datum 1953  
Origin of Levels: SS507 SO 42451 (EP6K) RL:44.04  
Source: LINZ Geodetic Database  
Location: Corner of Carrs Road and Tramway Road (under cover)

Lot connections and service lines plotted from data supplied by West Construction

To be read in conjunction with S&L Consultants Drawing 21338 - AB9 - R0

CKD BY	0	Issued For Work Clearance	11/17
REV No.		DESCRIPTION	DATE
Surveyed		NAME	DATE
Designed		SRC	Various
Drawn		BECA	10/16
Checked		SRC	11/17
Approved		TAM	11/17
SIGNED			

References



**HCC Ref:**  
011.2016.00006256.001 &  
011.2016.00006256.003

  
**S & L CONSULTANTS LTD**  
SURVEYORS - ENGINEERS - PLANNERS

36 Kereiti Street, Mt Maunganui, New Zealand  
P.O. Box 231 Ph: (07)577-6069  
Fax: (07)577-6065  
Email: slconsultants@slga.co.nz  
Web Site: www.slga.co.nz

Title

**Wastewater Asbuilt Plan  
Stage 6 & 7**



Copyright on this drawing is reserved


Original Scales @ A3 Date

**1:1000** 11/17

Do Not Scale Dimensions

Drawing No Revision

**21338 - AB8** 0

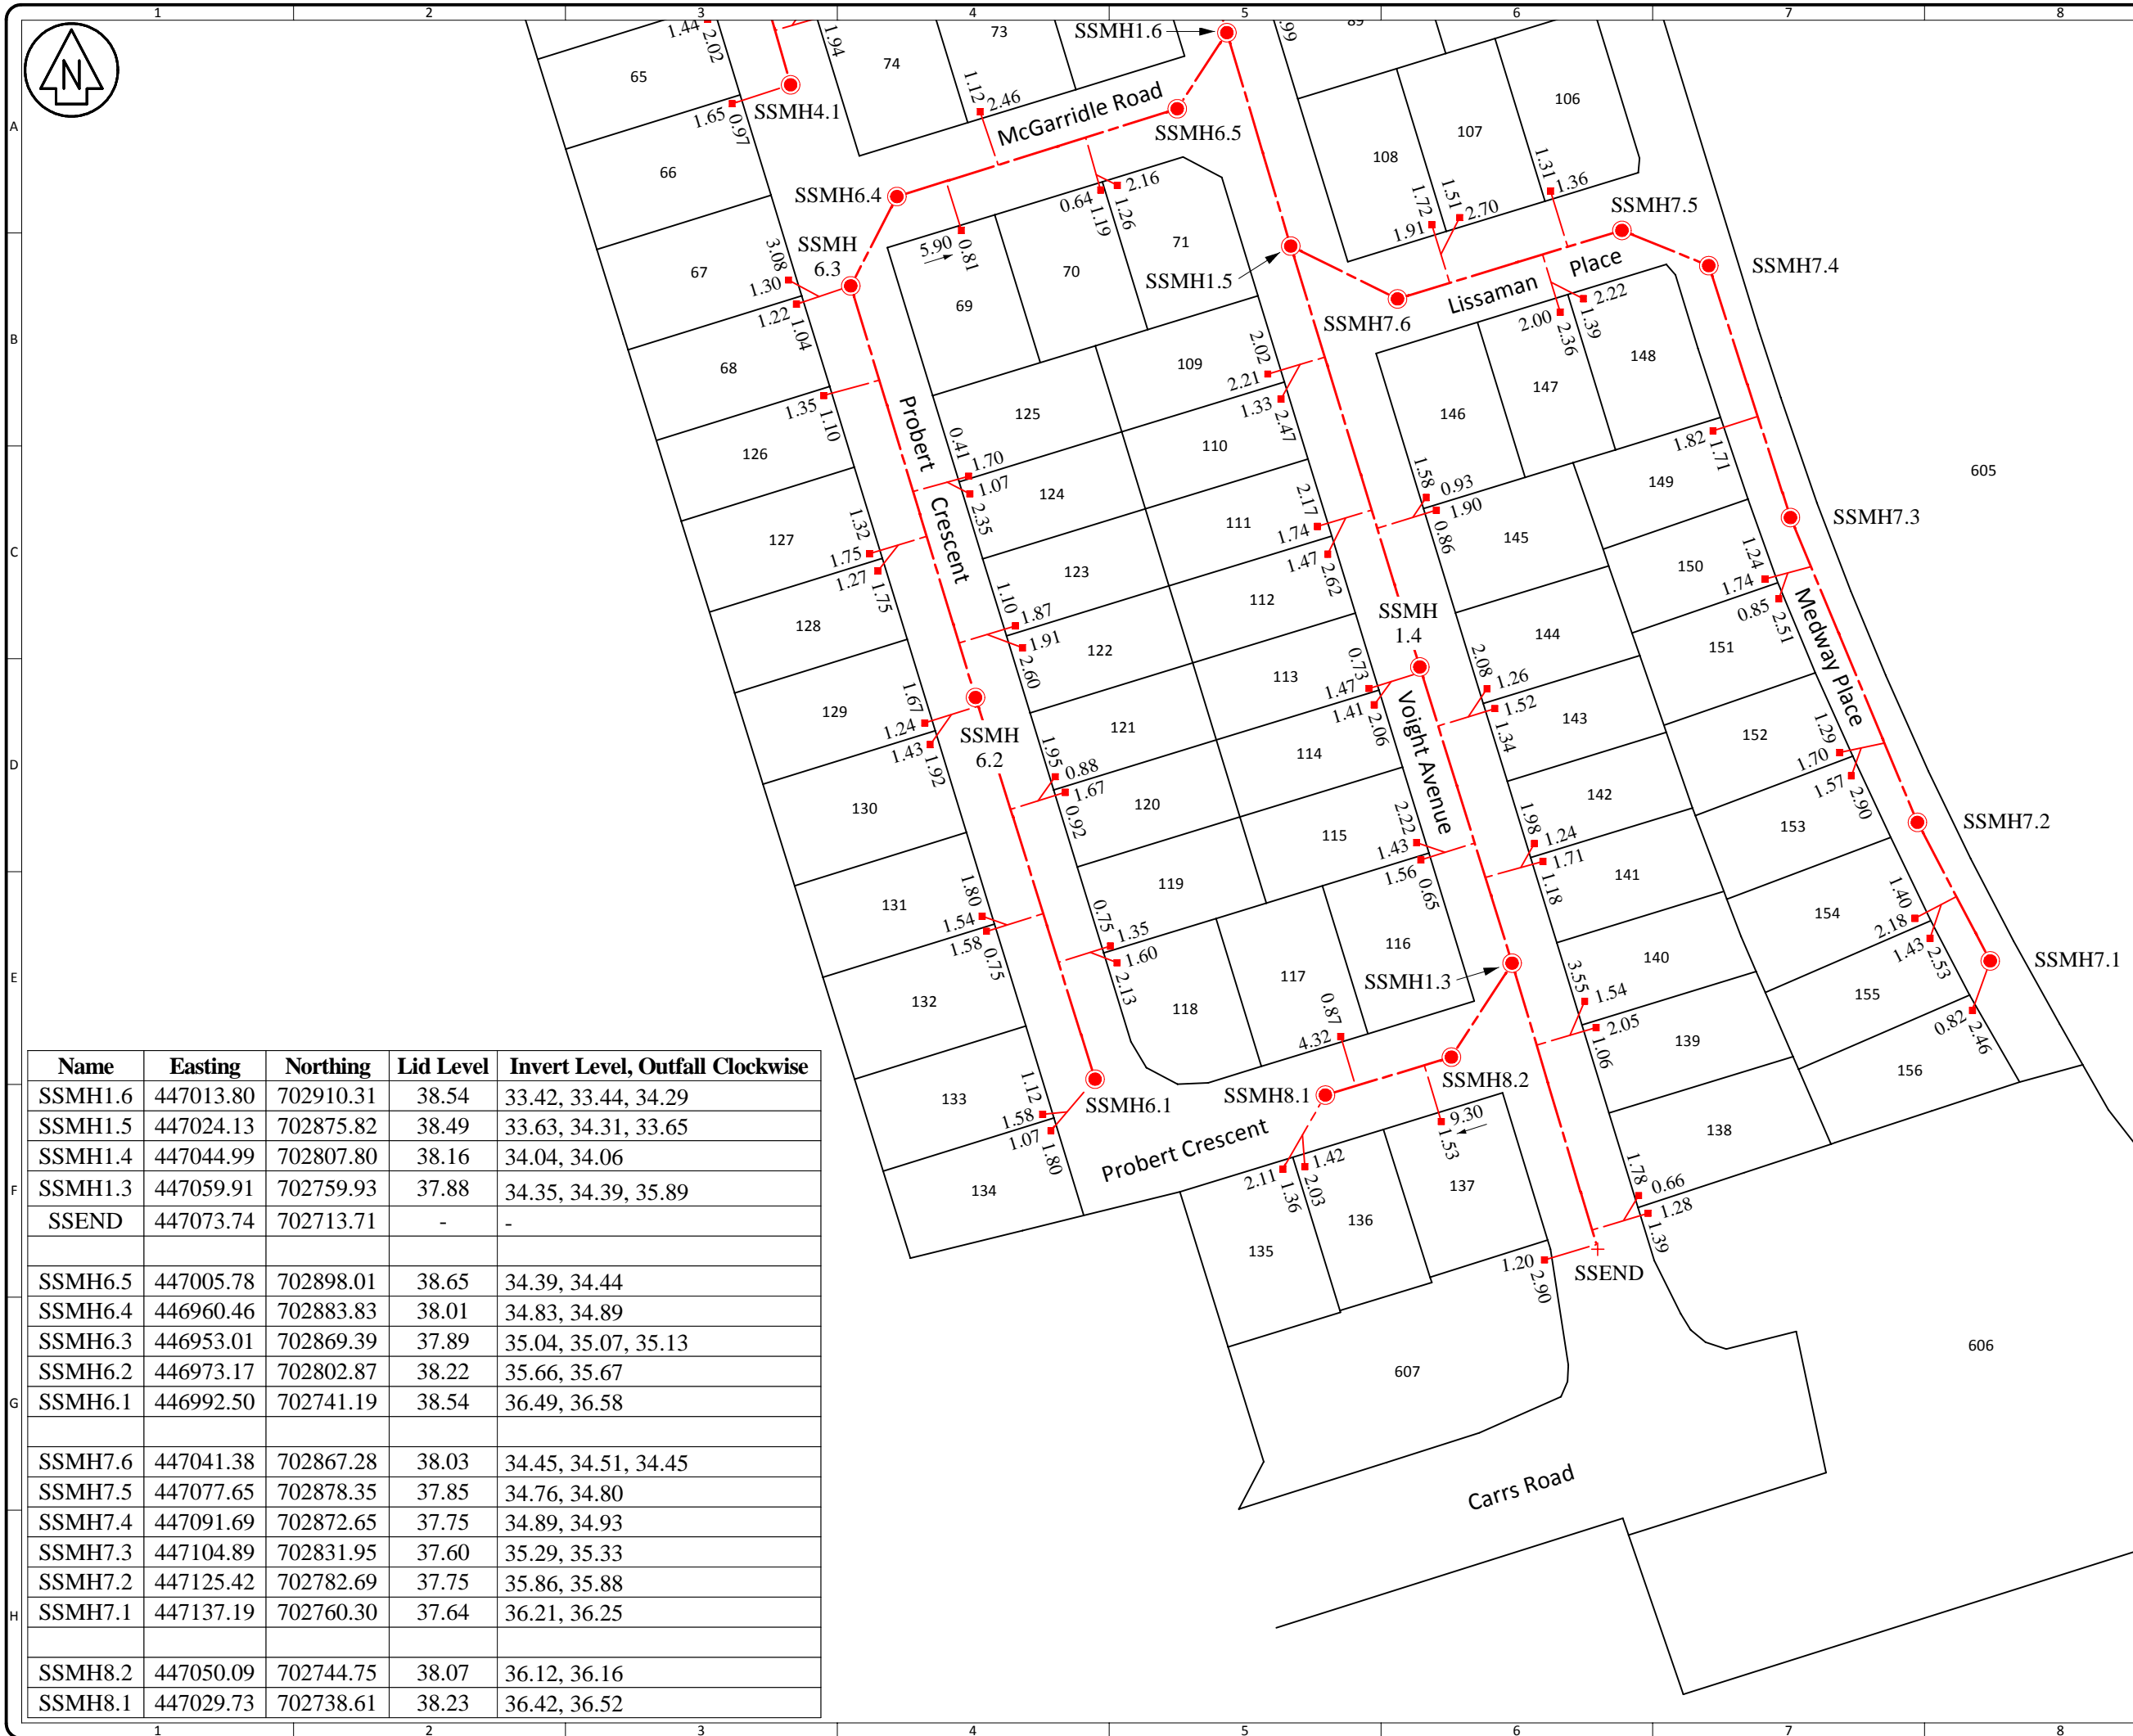

Name	Easting	Northing	Lid Level	Invert Level, Outfall Clockwise
SSMH1.6	447013.80	702910.31	38.54	33.42, 33.44, 34.29
SSMH1.5	447024.13	702875.82	38.49	33.63, 34.31, 33.65
SSMH1.4	447044.99	702807.80	38.16	34.04, 34.06
SSMH1.3	447059.91	702759.93	37.88	34.35, 34.39, 35.89
SEND	447073.74	702713.71	-	-
SSMH6.5	447005.78	702898.01	38.65	34.39, 34.44
SSMH6.4	446960.46	702883.83	38.01	34.83, 34.89
SSMH6.3	446953.01	702869.39	37.89	35.04, 35.07, 35.13
SSMH6.2	446973.17	702802.87	38.22	35.66, 35.67
SSMH6.1	446992.50	702741.19	38.54	36.49, 36.58
SSMH7.6	447041.38	702867.28	38.03	34.45, 34.51, 34.45
SSMH7.5	447077.65	702878.35	37.85	34.76, 34.80
SSMH7.4	447091.69	702872.65	37.75	34.89, 34.93
SSMH7.3	447104.89	702831.95	37.60	35.29, 35.33
SSMH7.2	447125.42	702782.69	37.75	35.86, 35.88
SSMH7.1	447137.19	702760.30	37.64	36.21, 36.25
SSMH8.2	447050.09	702744.75	38.07	36.12, 36.16
SSMH8.1	447029.73	702738.61	38.23	36.42, 36.52

**Notes:**  
Coordinates are in terms of Mt Eden 2000 Circuit  
Levels are in terms of Moturiki Vertical Datum 1953  
Origin of Levels: SS507 SO 42451 (EP6K) RL:44.04  
Source: LINZ Geodetic Database  
Location: Corner of Carrs Road and Tramway Road (under cover)  
Lot connections and service lines plotted from data supplied by West Construction  
To be read in conjunction with S&L Consultants Drawing 21338 - AB8 - R0



CKD BY	0	REV No.	Issued For Work Clearance	11/17
			DESCRIPTION	DATE
			NAME	DATE
			SIGNED	

References  
**HCC Ref:**  
**011.2016.00006256.001 & 011.2016.00006256.003**




**S & L CONSULTANTS LTD**  
SURVEYORS - ENGINEERS - PLANNERS  
36 Kereiti Street, Mt Maunganui, New Zealand  
P.O. Box 231 Ph:(07)577-6069  
Fax:(07)577-6065  
Email: slconsultants@slga.co.nz  
Web Site: www.slga.co.nz

Title  
**Wastewater Asbuilt Plan  
Stage 6 & 7**



Copyright on this drawing is reserved  
Original Scales @ A3  
**1:1000**  
Do Not Scale Dimensions  
Drawing No  
**21338 - AB9**  
Date  
**11/17**  
Revision  
**0**



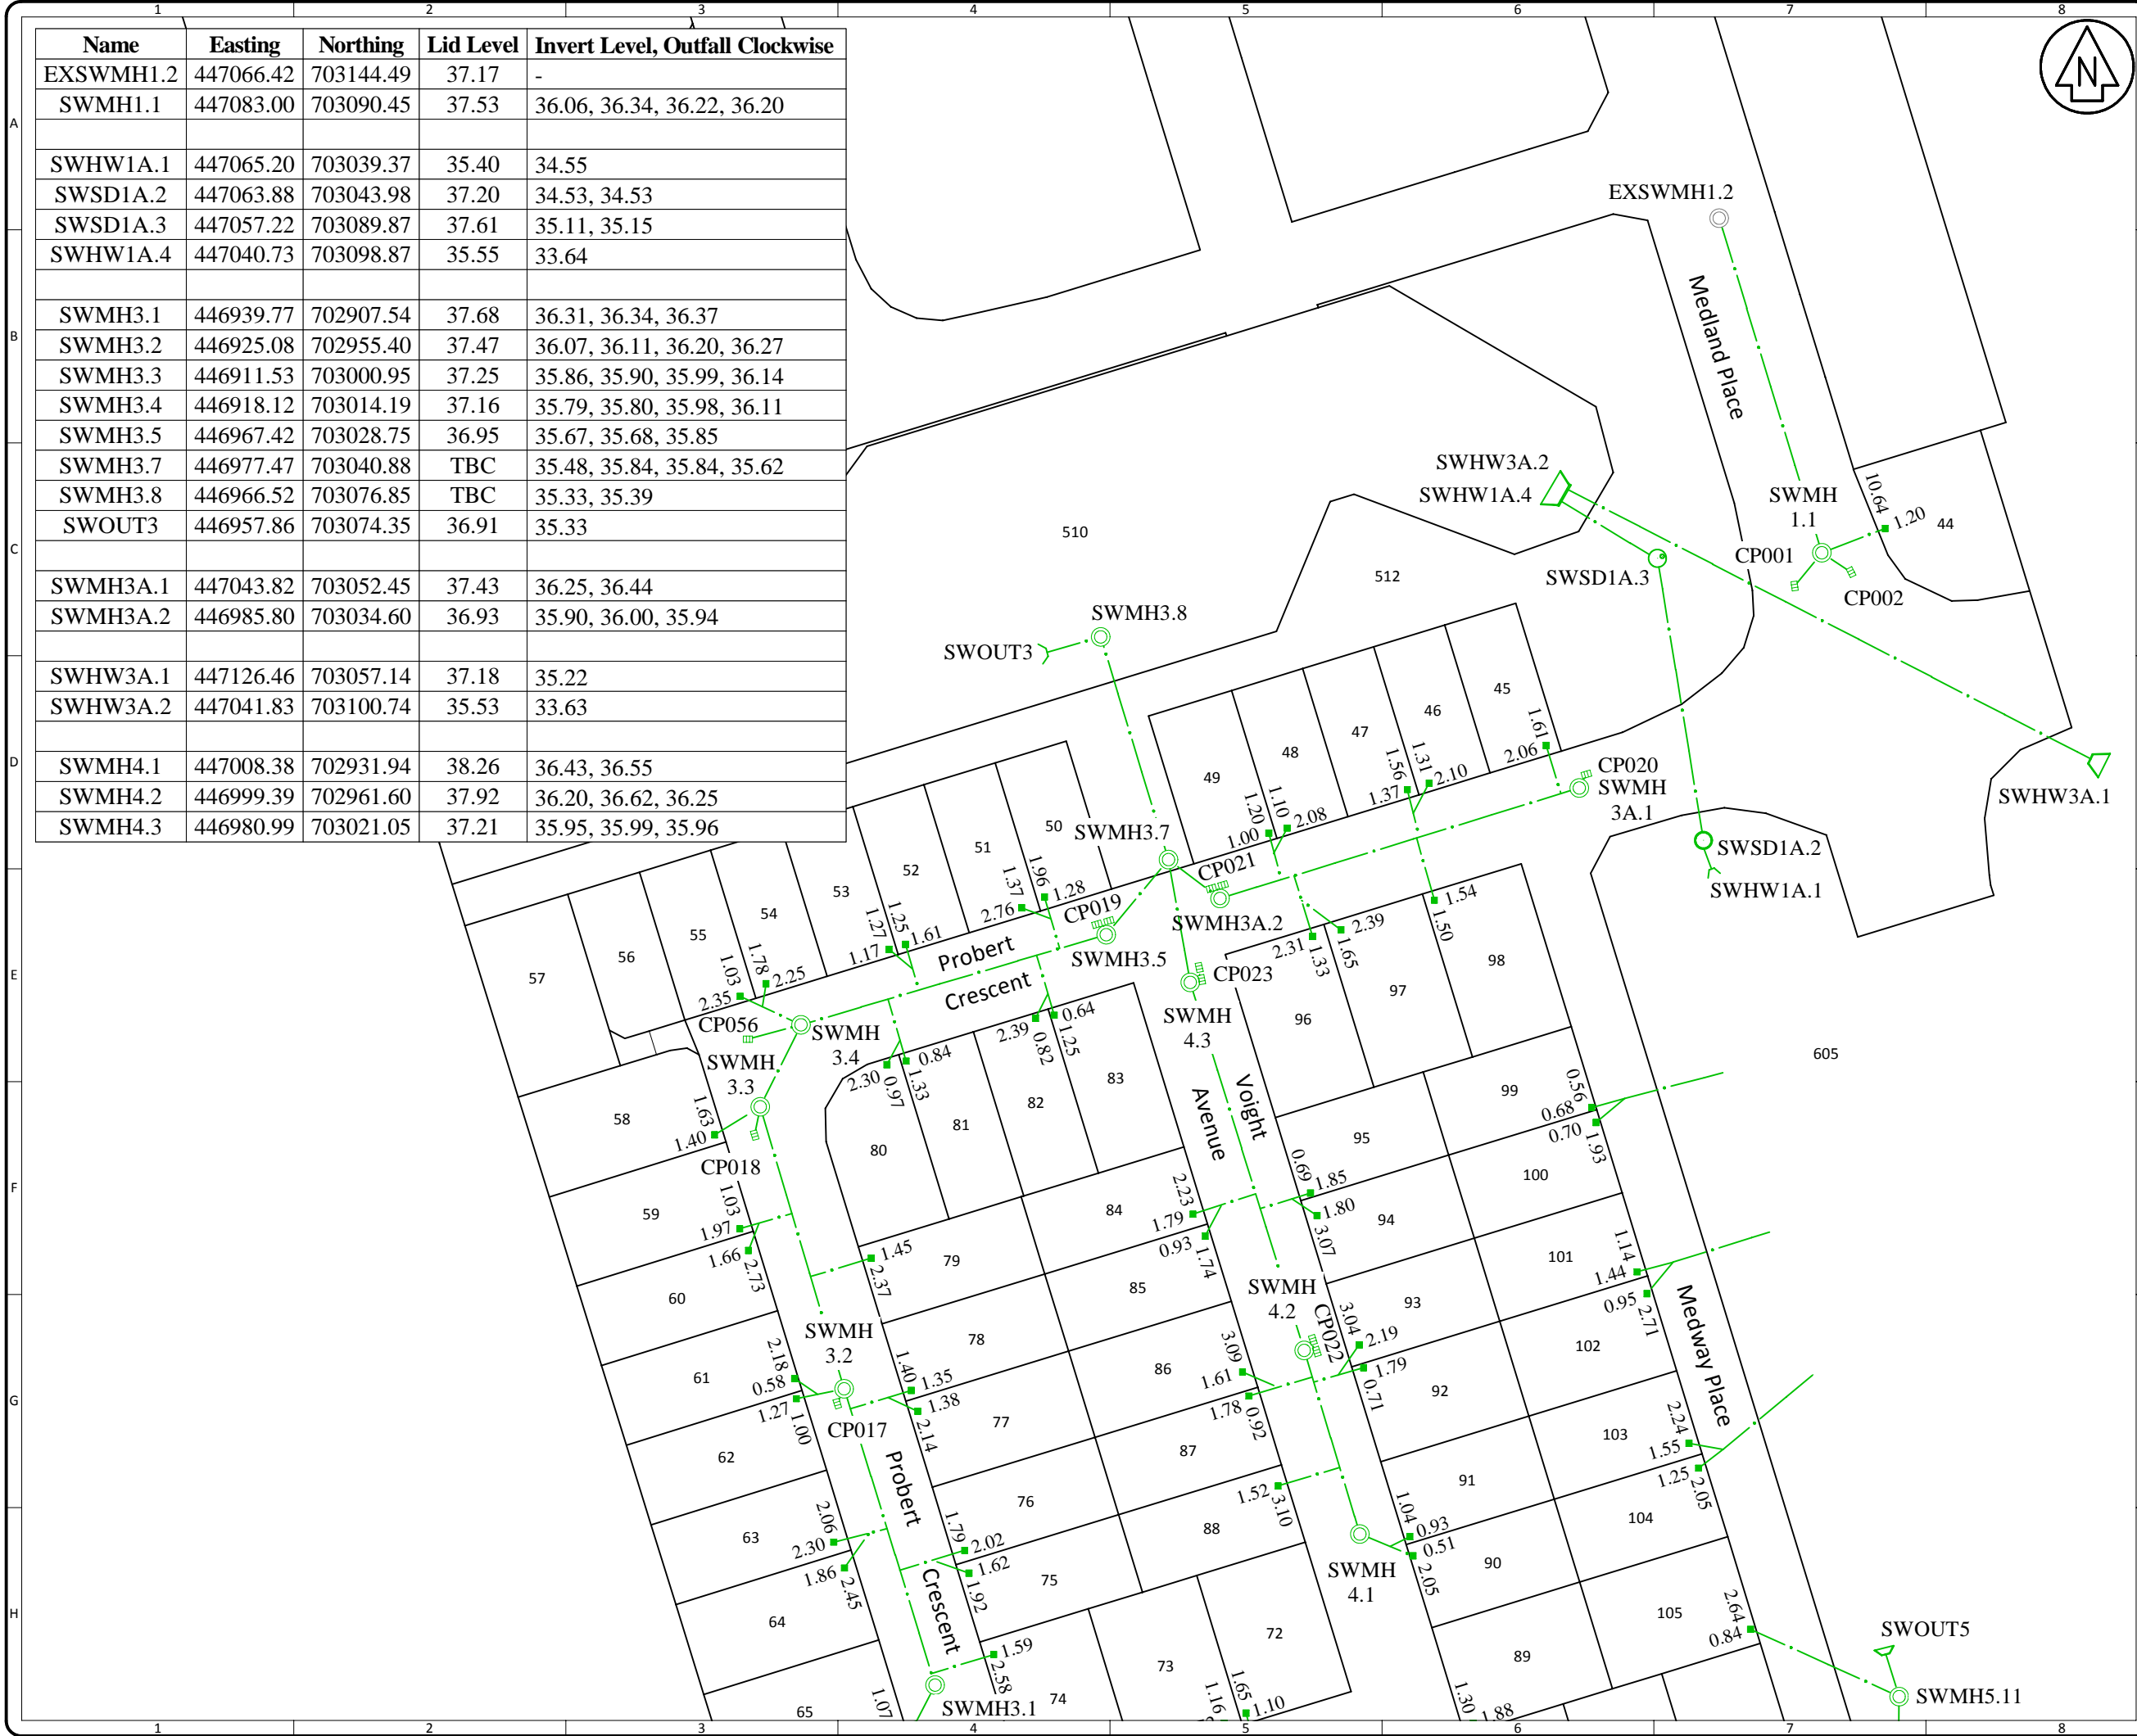

**Notes:**  
Coordinates are in terms of Mt Eden 2000 Circuit

Levels are in terms of Moturiki Vertical Datum 1953  
Origin of Levels: SS507 SO 42451 (EP6K) RL:44.04  
Source: LINZ Geodetic Database  
Location: Corner of Carrs Road and Tramway Road (under cover)

Lot connections and service lines plotted from data supplied by West Construction

To be read in conjunction with S&L Consultants Drawing 21338 - AB11 - R0

CKD BY	0	REV No.	Issued For Work Clearance	11/17
			DESCRIPTION	DATE
Surveyed			NAME	DATE
Designed			SRC	Various
Drawn			BECA	10/16
Checked			SRC	11/17
Approved			TAM	11/17
			SIGNED	

References


**HCC Ref:**  
**011.2016.00006256.001 & 011.2016.00006256.003**

  
S & L CONSULTANTS LTD  
SURVEYORS - ENGINEERS - PLANNERS

36 Kereiti Street, Mt Maunganui, New Zealand  
P.O. Box 231 Ph: (07)577-6069  
Fax: (07)577-6065  
Email: slconsultants@slga.co.nz  
Web Site: www.slga.co.nz


Title

**Stormwater Asbuilt Plan  
Stage 6 & 7**

  
Copyright on this drawing is reserved

Original Scales @ A3  
**1:1000**  
Do Not Scale Dimensions  
Drawing No  
**21338 - AB10**

Date  
**11/17**  
Revision  
**0**

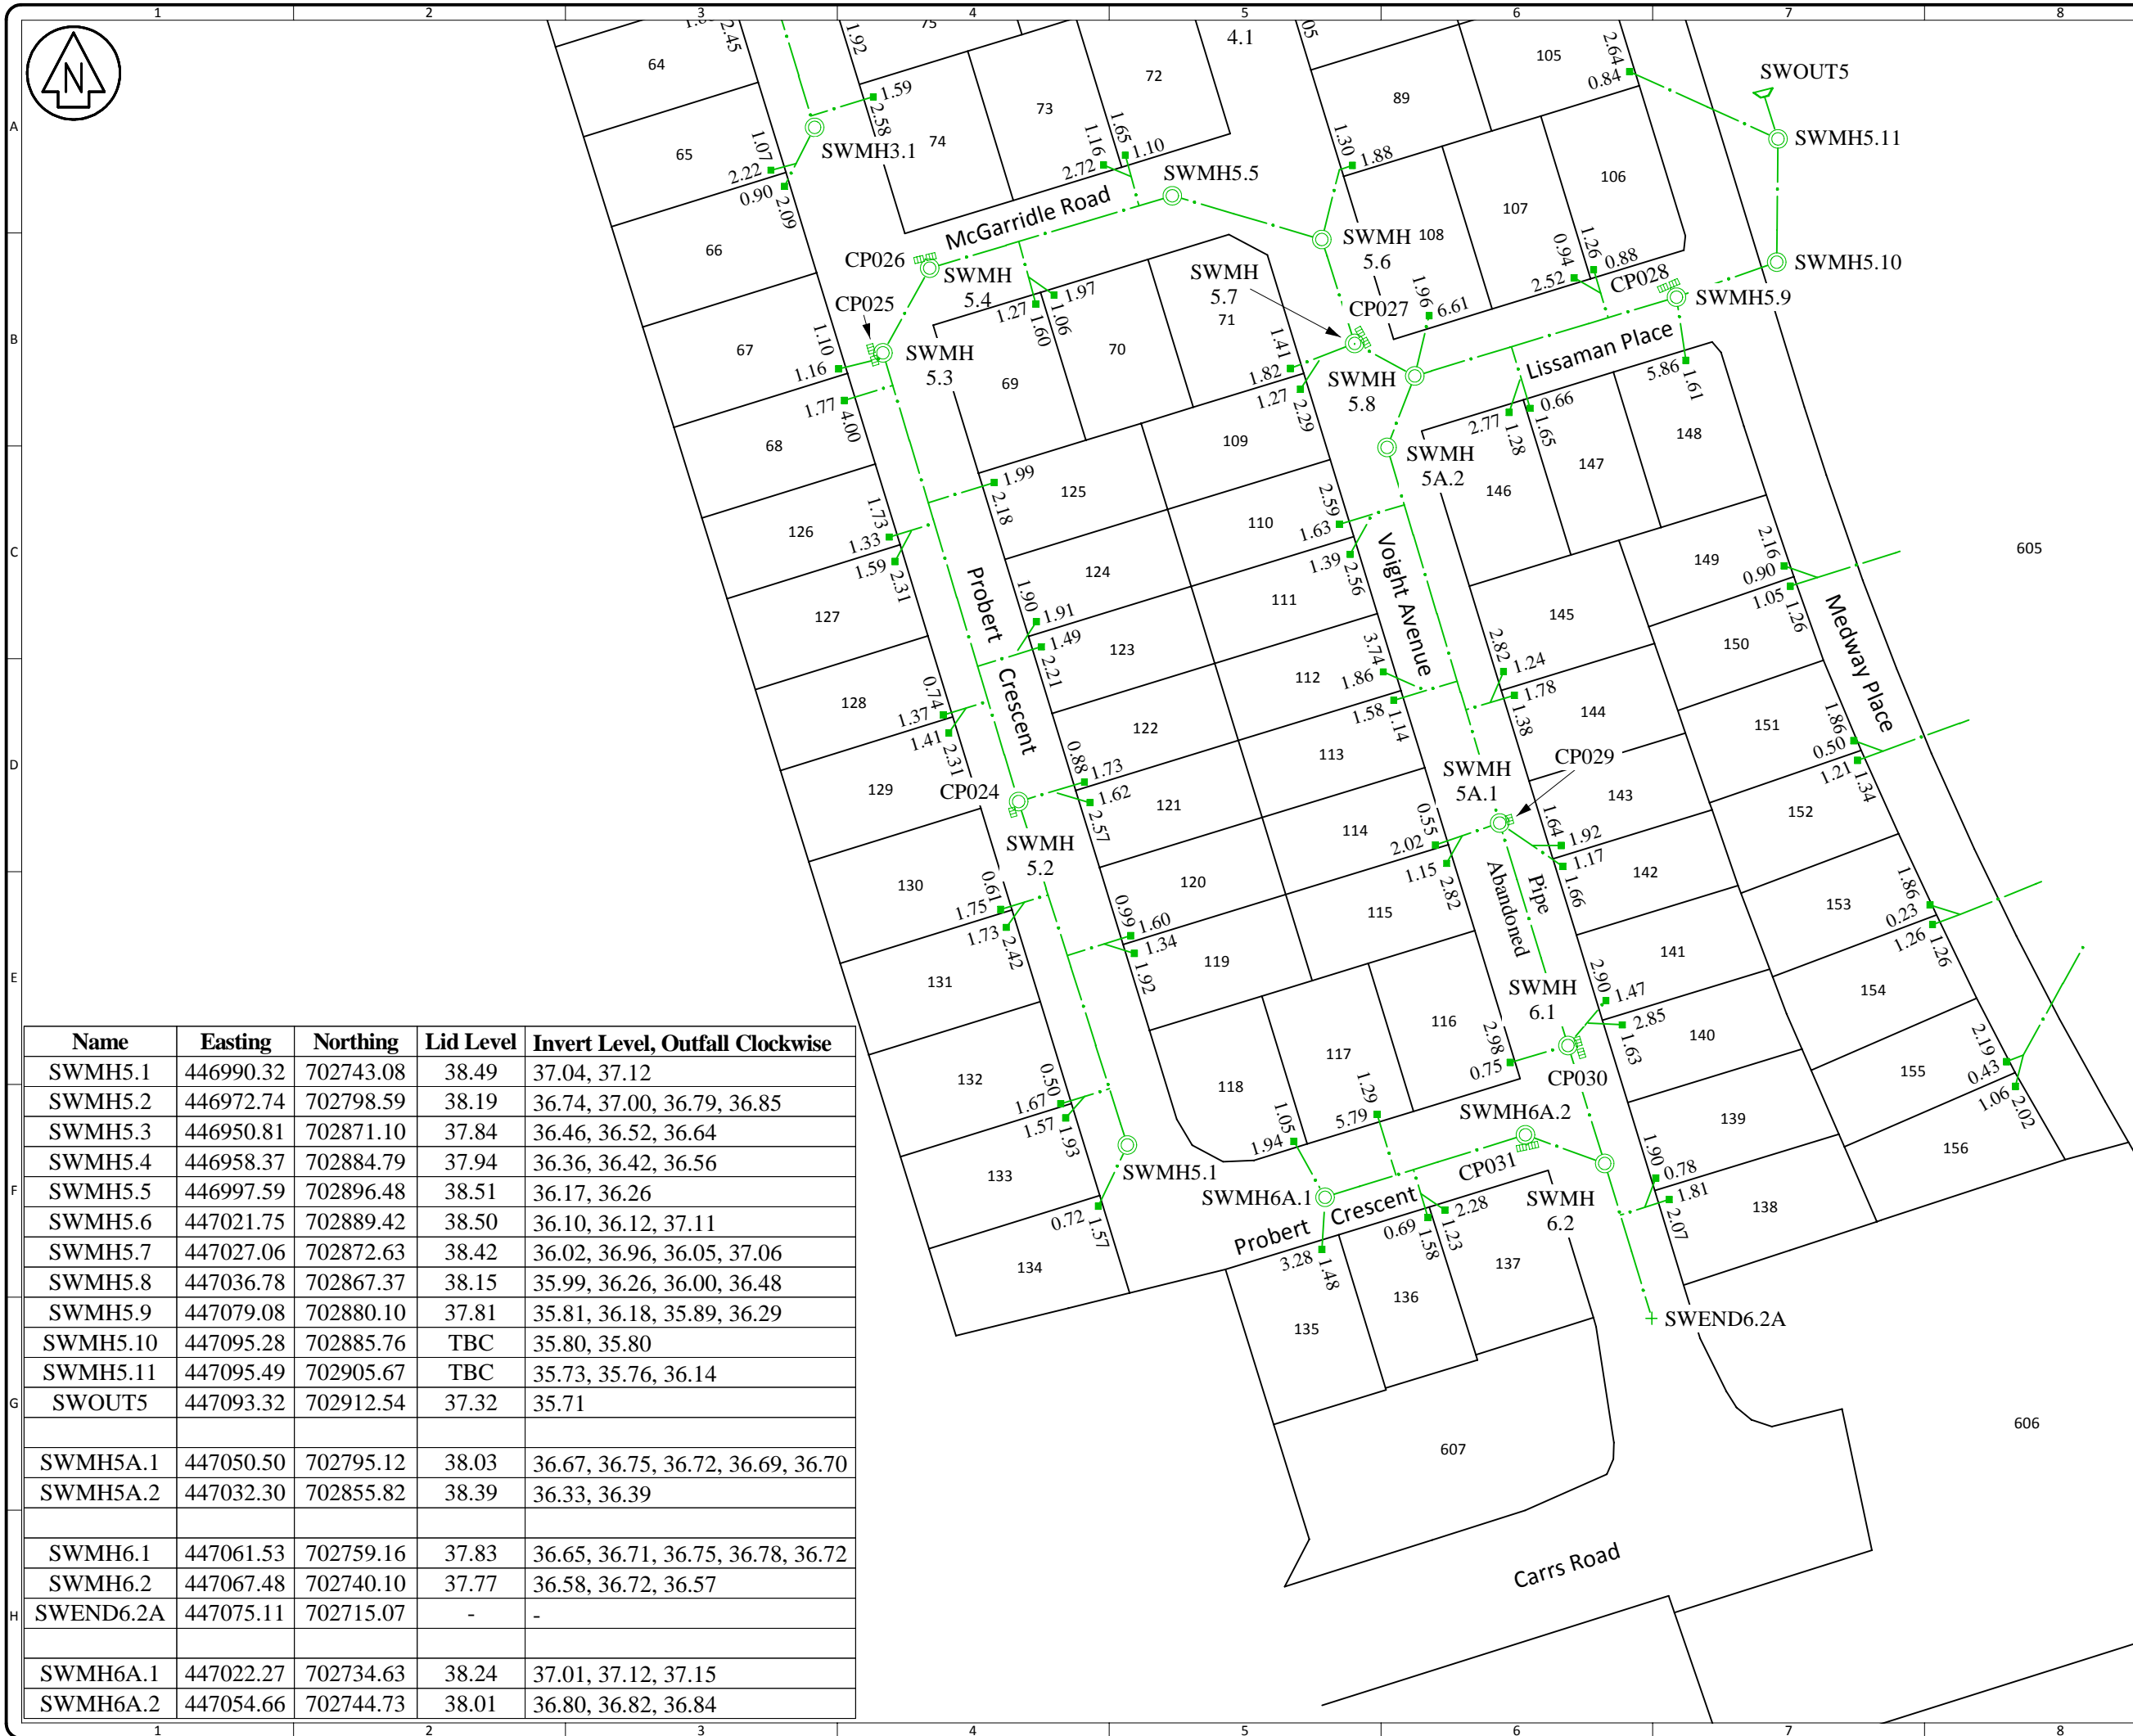

**Notes:**

Coordinates are in terms of Mt Eden 2000 Circuit

Levels are in terms of Moturiki Vertical Datum 1953  
Origin of Levels: SS507 SO 42451 (EP6K) RL:44.04  
Source: LINZ Geodetic Database  
Location: Corner of Carrs Road and Tramway Road (under cover)

Lot connections and service lines plotted from data supplied by West Construction

To be read in conjunction with S&L Consultants Drawing 21338 - AB10 - R0

CKD BY	0	Issued For Work Clearance	11/17
REV No.		DESCRIPTION	DATE
		NAME	DATE
		SIGNED	
Surveyed		SRC	Various
Designed		BECA	10/16
Drawn		SRC	11/17
Checked		SRC	11/17
Approved		TAM	11/17

References

**HCC Ref:**  
**011.2016.00006256.001 & 011.2016.00006256.003**





**S & L CONSULTANTS LTD**  
SURVEYORS - ENGINEERS - PLANNERS

36 Kereiti Street, Mt Maunganui, New Zealand  
P.O. Box 231 Ph:(07)577-6069  
Fax:(07)577-6065  
Email: slconsultants@slga.co.nz  
Web Site: www.slga.co.nz

Title

**Stormwater Asbuilt Plan  
Stage 6 & 7**




Copyright on this drawing is reserved

Original Scales @ A3 Date  
**1:1000** **11/17**

Do Not Scale Dimensions  
Drawing No Revision  
**21338 - AB11** **0**



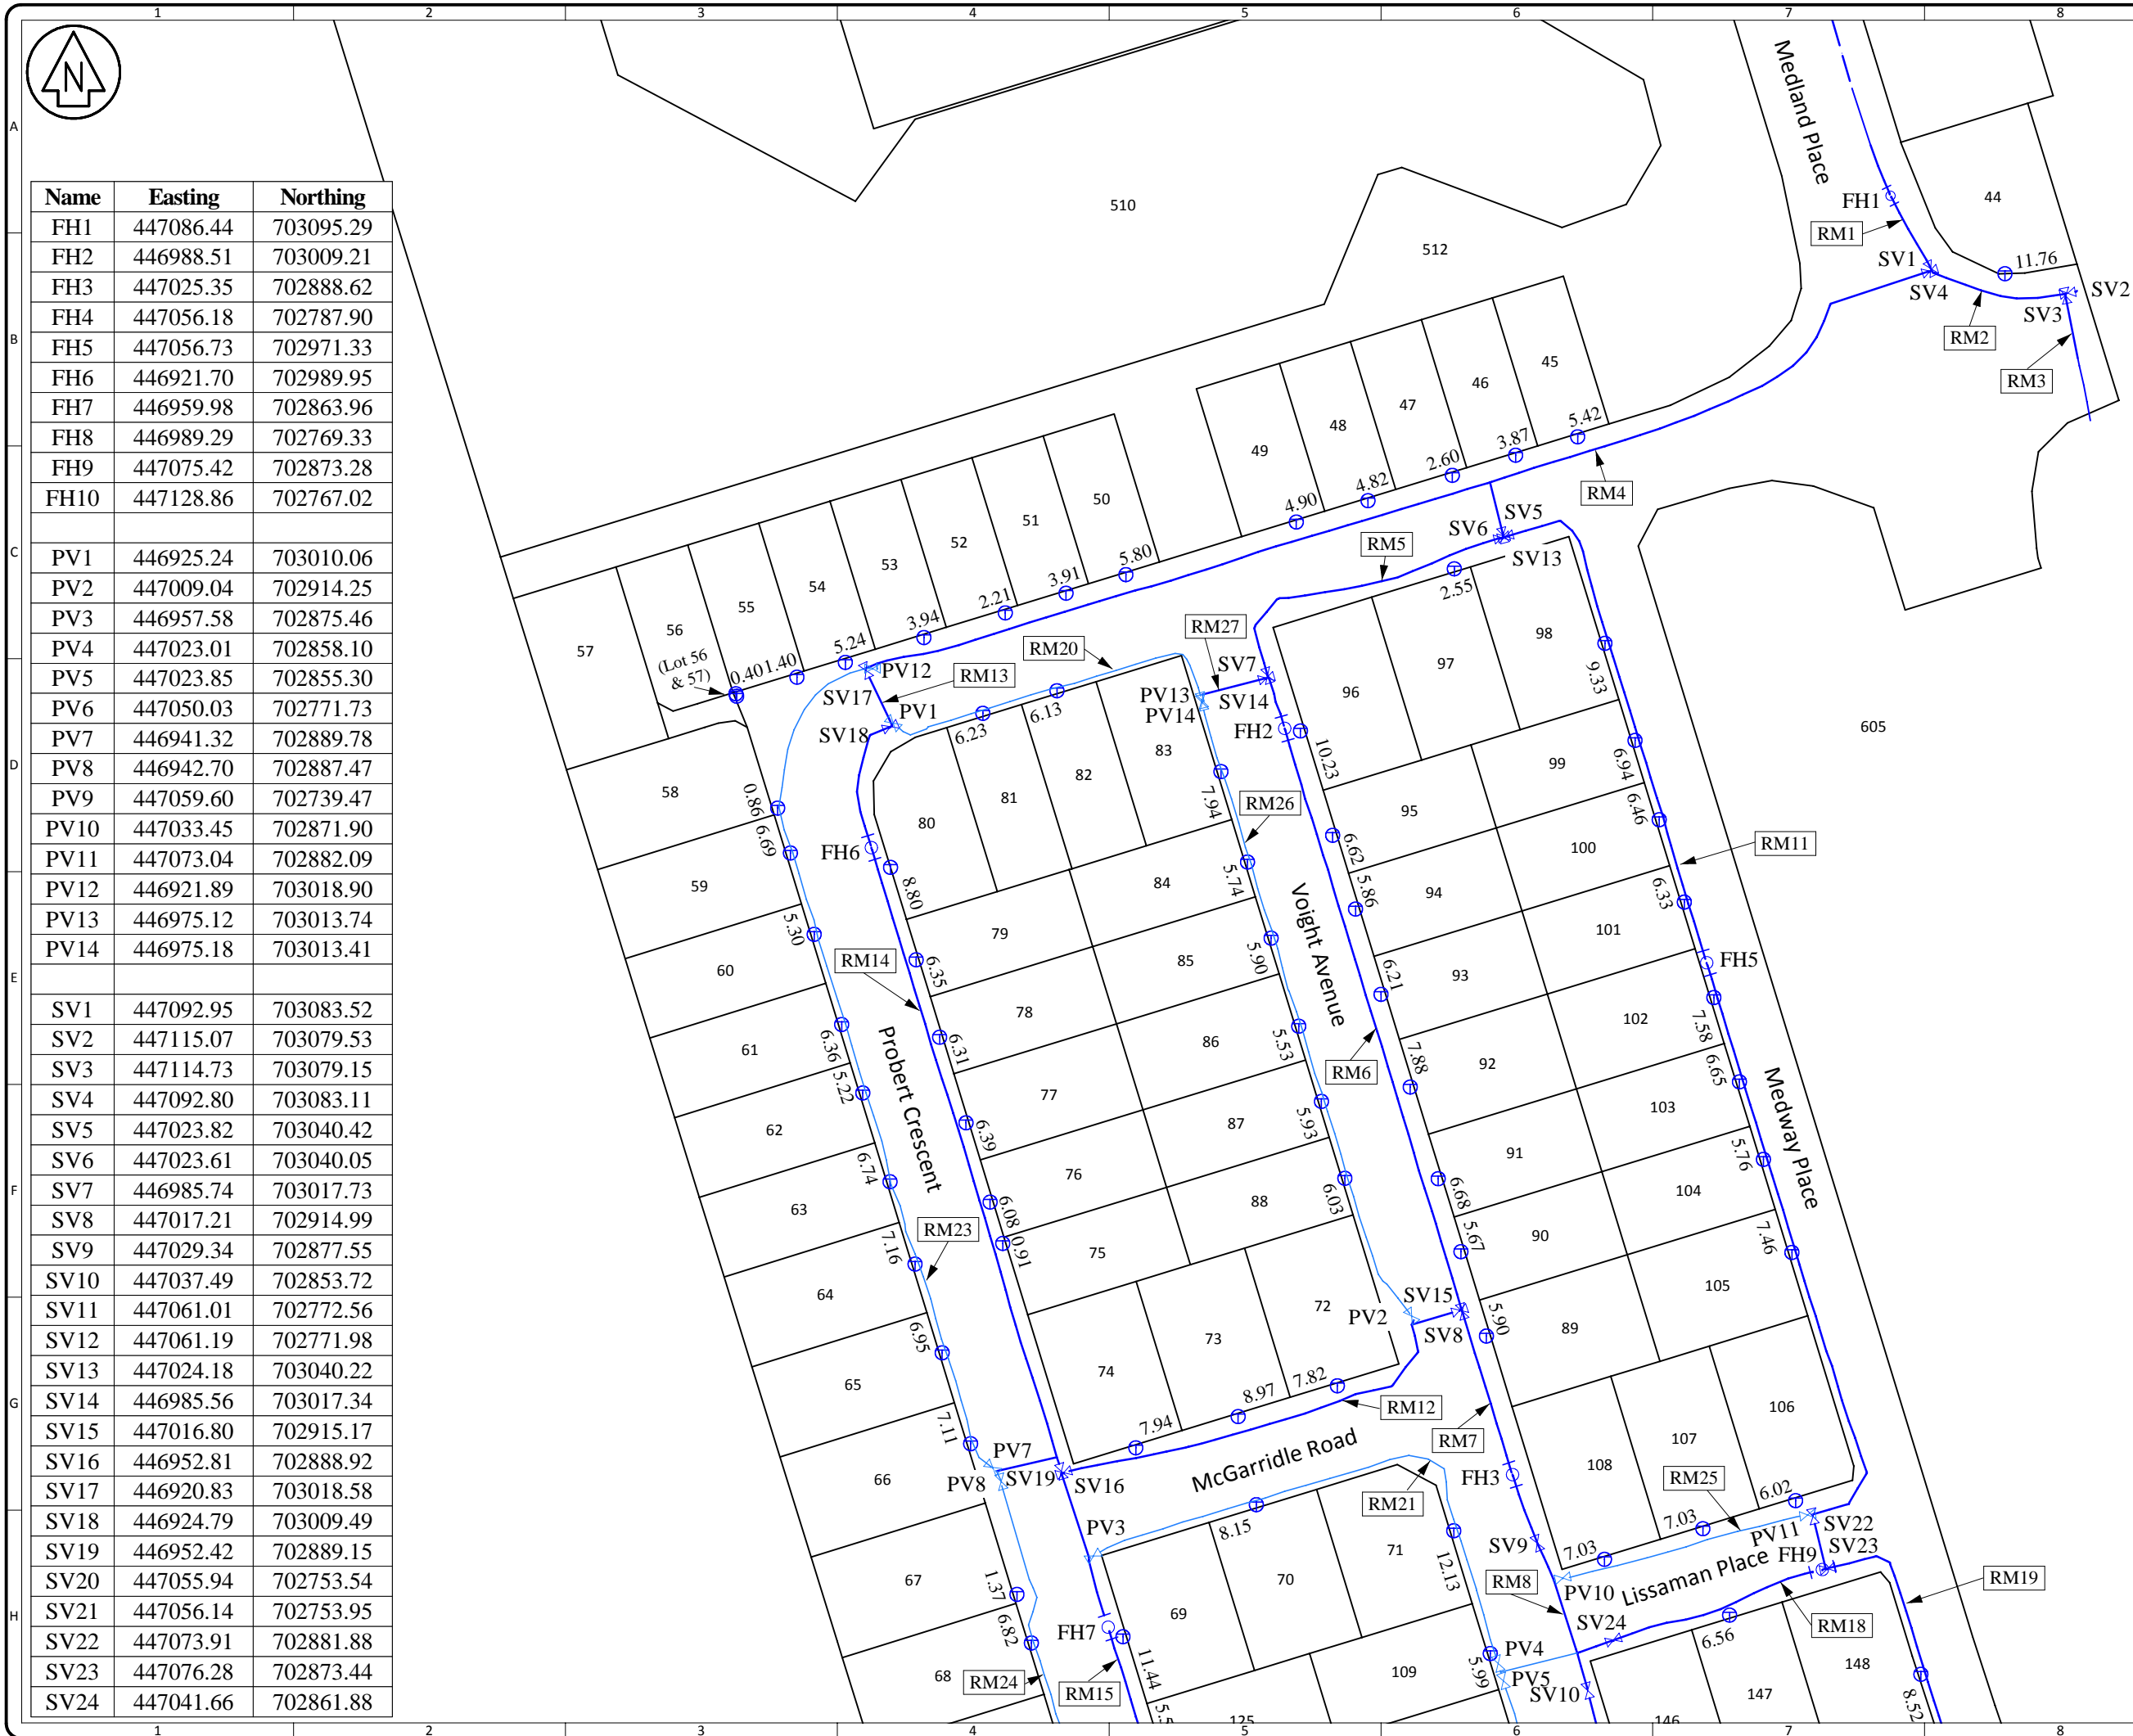








Coordinates are in terms of  
Mt Eden 2000 Circuit

A	<p>Levels are in terms of Moturiki Vertical Datum 1953</p> <p>Origin of Levels: SS507 SO 42451 (EP6K) RL:44.04</p> <p>Source: LINZ Geodetic Database</p> <p>Location: Corner of Carrs Road and Tramway Road (under cover)</p>
---	---

Watermains plotted from data supplied by Online Contractors

To be read in conjunction with  
S&L Consultants Drawing  
21338 - AB13 - R0

Key	
	Water Pipe - 150
	Water Pipe - 63
	Existing Water Pipe - 150
	Fire Hydrant
	Sluice Valve
	Gate Valve
	Water Connection

D		0	Issued For Work Clearance		1
	CRD BY	REV No.	DESCRIPTION		D
			NAME	DATE	SIGN
	Surveyed	SRC	Various		
	Designed	BECA	10/16		
	Drawn	SRC	11/17		
	Checked	SRC	11/17		
	Approved	TMB	11/17		


References

**HCC Ref:**  
**011.2016.00006256.001 &**  
**011.2016.00006256.003**



Title

**Water Asbuilt Plan  
Stage 6 & 7**

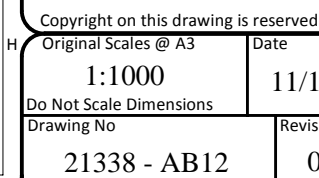





**Notes:**  
Coordinates are in terms of Mt Eden 2000 Circuit  
Levels are in terms of Moturiki Vertical Datum 1953  
Origin of Levels: SS507 SO 42451 (EP6K) RL:44.04  
Source: LINZ Geodetic Database  
Location: Corner of Carrs Road and Tramway Road (under cover)

Watermains plotted from data supplied by Online Contractors

To be read in conjunction with S&L Consultants Drawing 21338 - AB12 - R0

**Key**

- Water Pipe - 150
- Water Pipe - 63
- Existing Water Pipe - 150
- Fire Hydrant
- Sluice Valve
- Gate Valve
- Water Connection

CKD BY	0	Issued For Work Clearance	11/17
REV No.		DESCRIPTION	DATE
Surveyed		NAME	DATE
Designed		SRC	Various
Drawn		BECA	10/16
Checked		SRC	11/17
Approved		TMB	11/17

References  
**HCC Ref:**  
011.2016.00006256.001 & 011.2016.00006256.003

**S & L CONSULTANTS LTD**  
SURVEYORS · ENGINEERS · PLANNERS  
36 Kereiti Street, Mt Maunganui, New Zealand  
P.O. Box 231 Ph:(07)577-6069 Fax:(07)577-6065  
Email: slconsultants@slga.co.nz Web Site: www.slga.co.nz

Title  
**Water Asbuilt Plan Stage 6 & 7**

**Chedworth Properties Limited** **GREENHILL PARK**  
Copyright on this drawing is reserved

Original Scales @ A3	Date
1:1000	11/17
Do Not Scale Dimensions	
Drawing No	Revision
21338 - AB13	0